


RACK PRINCIPAL 600mm

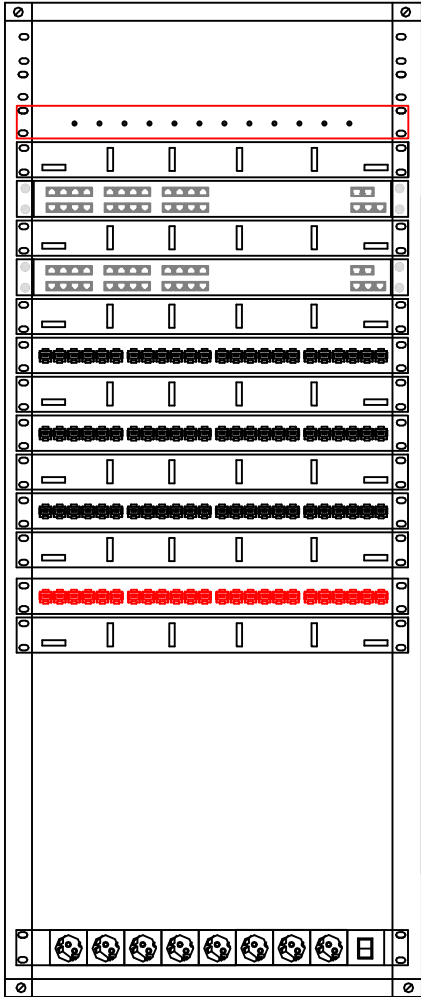


- PANEL DISTRIBUIDOR 12 F.O. (1 U)
- PANEL PASAHILOS (1 U)
- SWITCH 48 PUERTOS 10/100/1000 Mbps
- PANEL PASAHILOS (1 U)
- SWITCH 24 PUERTOS 10/100/1000 Mbps
- PANEL PASAHILOS (1 U)
- PANEL (Pach) 24xRJ45 (Datos)
- PANEL PASAHILOS (1 U)
- PANEL (Pach) 24xRJ45 (Datos)
- PANEL PASAHILOS (1 U)
- PANEL (Pach) 24xRJ45 (Datos)
- PANEL PASAHILOS (1 U)
- PANEL (Pach) 24xRJ45 (Voz)
- PANEL PASAHILOS (1 U)

BASES 8 SCHUKO (1 U)

- 1
- 2
- PANEL DISTRIBUIDOR 12 F.O. (1 U)
- PANEL PASAHILOS (1 U)
- SWITCH 48 PUERTOS 10/100/1000 Mbps
- PANEL PASAHILOS (1 U)
- SWITCH 24 PUERTOS 10/100/1000 Mbps
- PANEL PASAHILOS (1 U)
- PANEL (Pach) 24xRJ45 (Datos)
- PANEL PASAHILOS (1 U)
- PANEL (Pach) 24xRJ45 (Datos)
- PANEL (Pach) 24xRJ45 (Datos)
- PANEL PASAHILOS (1 U)
- BASES 8 SCHUKO (1 U)


RACK PLANTA 1ª 600mm

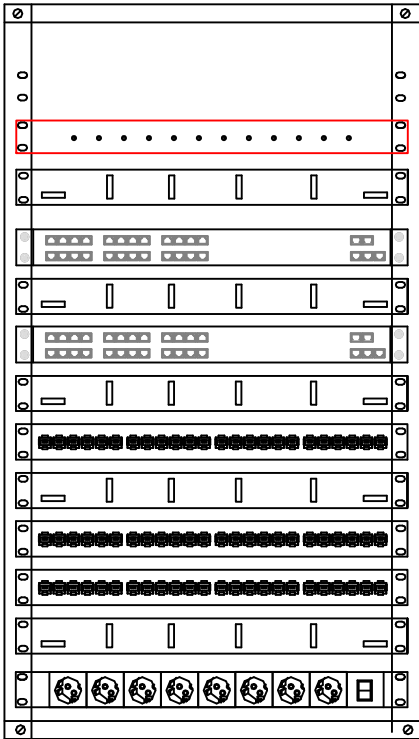

- 1
- 2
- 3
- PANEL DISTRIBUIDOR 12 F.O. (1 U)
- PANEL PASAHILOS (1 U)
- SWITCH 48 PUERTOS 10/100/1000 Mbps
- PANEL PASAHILOS (1 U)
- PANEL (Pach) 24xRJ45 (Datos)
- PANEL PASAHILOS (1 U)
- PANEL (Pach) 24xRJ45 (Datos)
- BASES 8 SCHUKO (1 U)

RACK PLANTA 2ª 600mm

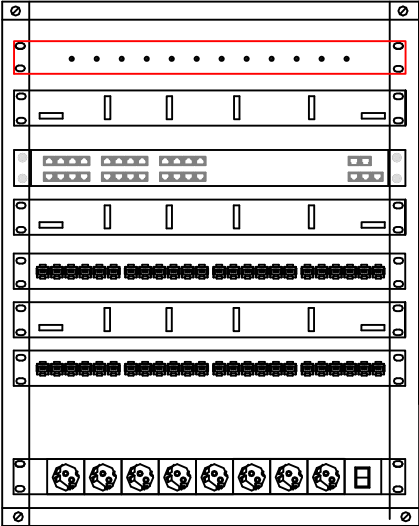

- 1
- 2
- 3
- 4
- 5
- 6
- 7
- 8
- 9
- 10
- 11
- 12